

Work Order ID 160771

Wednesday, May 03, 2017 3:48:55 PM

160771

Page 1

Item ID: 646.9701 Accept ***N900040100*** Setup Start ***NS1***
 Revision ID: Stop ***NS2***
 Item Name: Cutter Sub Assembly
 Start Date: 5/8/2017 Start Qty: 3.00 ***3*** Cust Item ID:
 Required Date: 5/11/2017 Req'd Qty: 3.00 ***3*** Customer:
 Reference: (P.A.)SCHEDULED/S

Approvals: Process Plan: PA **DAS 21 9-89** Date: 2017/05/05 Tooling: _____ Date: _____ Run Start ***NR1***
 QC: _____ Date: _____ SPC (Y/N): _____ Date: _____ Stop ***NR2***

Sequence ID/ Work Center ID	Operation Description	Set Up/ Run Hours	Tool ID	Tool #	Plan Code	Accept Qty	Reject Qty	Reject Number	Insp. Stamp
Draw Nbr	Revision Nbr								
646.9700	REV D2								

110 Pick Kit 0.00

110

Packaging Memo 0.00

Packaging

DAS 6 17/5/5 9-89

120 0.00

120

Small Fab Memo 0.55

Small Fab

Assemble as per dwg and apply loctite 598 on all faying surfaces per note.

A/R RTV LOCTITE 598: 137353
 exp. date: 02/19

5X 17/05/12 DAS 36 9-89

130 QC5- Inspect part completeness to step on W/O 0.00

130

QC Memo 0.06

Quality Control

5 DAS 38 9-89 MAY 12 2017

DQA: _____ Date: _____



WORK ORDER NON-CONFORMANCE / UPDATE

QA Closed: _____ Date: _____

Work Order update only ☐

Work Order: _____ Part No. _____ NCR No. _____		DISPOSITION Rework ☐ Scrap ☐ Use-as-is ☐ Suspected Unapproved ☐		AGAINST DEPARTMENT/PROCESS Skid-tube ☐ Machining ☐ Thermoforming ☐ Large Fab ☐ Cross tube ☐ Small Fab ☐ Finishing ☐ Composite ☐ Water Jet ☐ Prod. Eng. Coord. ☐ Rec/Store/Packaging ☐ Supplier ☐ Engineering ☐ Quality ☐ Other ☐					
Date :		Step #:		QTY Effective :			MRB (QSI042) Approval		
Description Work Order Deviation				Disposition				Completed By Lead hand / Supervisor Approval Verification QC / QA Coordinator Approval	
Root Cause		FAULT CATEGORY							
Environment ☐	No Re-verification ☐	Pressure/Forced ☐	Temperature/Cure ☐	Power Loss/Surge ☐	Positioned Wrong ☐				
Design ☐	Operator ☐	Bending ☐	Set-up ☐	Folio/Program ☐	Outside Dimensions ☐				
Doc/Data ☐	Offset/Setup ☐	Centre Not Concentric ☐	BOM/Route ☐	Grain ☐	Over/Under tolerance ☐				
Equip/Tooling ☐	Supplier ☐	Cracks ☐	Broken/Damage/Defect ☐	Weld ☐	Part Incorrect ☐				
Handling/Pre ☐	Training ☐	Crimp/Kink/Ripple/Wave ☐	Inspection Incomplete/Unqualified ☐	Wrong Stock Pulled ☐	Part Lost/Missing ☐				
Material ☐	Use for Testing ☐	Cuffs ☐	Contamination ☐	Out of Sequence ☐	Part Moved ☐				
Internal Transport ☐	Poor Information ☐	Crushing ☐	Countersink ☐	Off-set ☐	Drawing ☐				
Tribal Knowledge ☐	Rushing ☐	Heat Treat ☐	Cut Too Short ☐	Mislabeled ☐	Finish ☐				
LOA ☐	Product Improvement ☐	Wave/Twist in Tube ☐	Instructions Incomplete/Unclear ☐	Fit/Function ☐	Misread ☐				
Substation ☐	Process Improvement ☐	Marks/Chatter ☐	Drill Holes ☐	Misaligned/off center ☐	Turning Sequence ☐				
Past Expiry Date ☐	Manufacturing Process ☐								
Misidentified ☐	Past Due ☐								
		OTHER : ☐							

Work Order ID 160771

Wednesday, May 03, 2017 3:48:55 PM

160771

Page 2

Item ID: 646.9701 Accept ***N900040100*** Setup Start ***NS1***
Revision ID: Stop ***NS2***
Item Name: Cutter Sub Assembly
Start Date: 5/8/2017 Start Qty: 3.00 ***3*** Cust Item ID:
Required Date: 5/11/2017 Req'd Qty: 3.00 ***3*** Customer:
Reference: (P.A.)SCHEDULED/S

Approvals: Process Plan: Date: Tooling: Date: Run Start ***NR1***
QC: Date: SPC (Y/N): Date: Stop ***NR2***

Sequence ID/ Work Center ID	Operation Description	Set Up/ Run Hours	Tool ID	Tool #	Plan Code	Accept Qty	Reject Qty	Reject Number	Insp. Stamp
140	Identify as per dwg & Stock Location. <u>CCK007</u>	0.00							
140						DAS 5 6 J-89			
Packaging	Memo	0.03							
Packaging	***IDENTIFY AS PER IAW MPP-120***								MAY 17 2017
150	QC21- Final Inspection - Work Order Release	0.00							
150									
QC	Memo	0.30							17/5/17 
Quality Control									

DAS
21
9-89

MAY 17 2017

DQA: _____ Date: _____



WORK ORDER NON-CONFORMANCE / UPDATE

QA Closed: _____ Date: _____

Work Order update only ☐

Work Order: _____ Part No. _____ NCR No. _____		DISPOSITION Rework ☐ Scrap ☐ Use-as-is ☐ Suspected Unapproved ☐		AGAINST DEPARTMENT/PROCESS Skid-tube ☐ Machining ☐ Thermoforming ☐ Large Fab ☐ Cross tube ☐ Small Fab ☐ Finishing ☐ Composite ☐ Water Jet ☐ Prod. Eng. Coord. ☐ Rec/Store/Packaging ☐ Supplier ☐ Engineering ☐ Quality ☐ Other ☐					
Date :		Step #:		QTY Effective :			MRB (QSI042) Approval Completed By _____ Lead hand / Supervisor Approval Verification _____ QC / QA Coordinator Approval _____		
Description Work Order Deviation				Disposition					
Root Cause Environment ☐ Design ☐ Doc/Data ☐ Equip/Tooling ☐ Handling/Pre ☐ Material ☐ Internal Transport ☐ Tribal Knowledge ☐ LOA ☐ Substation ☐ Past Expiry Date ☐ Misidentified ☐ No Re-verification ☐ Operator ☐ Offset/Setup ☐ Supplier ☐ Training ☐ Use for Testing ☐ Poor Information ☐ Rushing ☐ Product Improvement ☐ Process Improvement ☐ Manufacturing Process ☐ Past Due ☐		FAULT CATEGORY Pressure/Forced ☐ Bending ☐ Centre Not Concentric ☐ Cracks ☐ Crimp/Kink/Ripple/Wave ☐ Cuffs ☐ Crushing ☐ Heat Treat ☐ Wave/Twist in Tube ☐ Marks/Chatter ☐ Temperature/Cure ☐ Set-up ☐ BOM/Route ☐ Broken/Damage/Defect ☐ Inspection Incomplete/Unqualified ☐ Contamination ☐ Countersink ☐ Cut Too Short ☐ Instructions Incomplete/Unclear ☐ Drill Holes ☐ Power Loss/Surge ☐ Folio/Program ☐ Grain ☐ Weld ☐ Wrong Stock Pulled ☐ Out of Sequence ☐ Off-set ☐ Misabeled ☐ Fit/Function ☐ Misaligned/off center ☐ Positioned Wrong ☐ Outside Dimensions ☐ Over/Under tolerance ☐ Part Incorrect ☐ Part Lost/Missing ☐ Part Moved ☐ Drawing ☐ Finish ☐ Misread ☐ Turning Sequence ☐							
		OTHER : ☐							

Picklist Print

Wednesday, May 03, 2017 3:48:54 PM

Page 1

Work Order ID: 160771

160771

Parent Item: 646.9701

646 9701

Parent Item Name: Cutter Sub Assembly

Start Date: 5/8/2017

Required Date: 5/11/2017

Start Qty: 3.00

Required Qty: 3.00

Comments: IPP REV:A 12.08.13 NEW ISSUE DD VERF:JFS
:B AS PER REV D 16-03-07 JLM VERIFIED BY:JFS

IPP REV

Component Item ID/ Item Name	Replacement Item ID	Mfg/ Purch	Bin Item	Primary Location	Last Location	Route Seq ID	Unit of Measure	Qty on Hand	Qty per Kit	Total Qty	Qty Issued	Date Issued	Status
---------------------------------	------------------------	---------------	-------------	---------------------	------------------	-----------------	--------------------	----------------	----------------	--------------	---------------	----------------	--------

646.9710

Manufactured No

110

Each

22.0000

1

35

1008

646 9710

Body

**

MAY 04 2017

Location

Loc Qty

Loc Code

cck012

22

152187

2

156762

10

157197

10

2
3

646.9711

Manufactured No

110

Each

43.0000

2

6 10

1008

646 9711

Blade

**

MAY 04 2017

Location

Loc Qty

Loc Code

CCK106

23

153423

3

155350

10

156758

10

CCK108A

20

157192

20

1008

MS27039-08-19

Purchased No

110

Each

332.0000

6

18 30

1008

MS27039-08-19

Screw

**

MAY 04 2017

Location

Loc Qty

Loc Code

GA

30

m135948

26

m137178

4

ST277

302

m137320

102

m137361

200

30

DQA: _____ Date: _____



WORK ORDER NON-CONFORMANCE / UPDATE

QA Closed: _____ Date: _____

Work Order update only ☐

Work Order: _____ Part No. _____ NCR No. _____		DISPOSITION Rework ☐ Scrap ☐ Use-as-is ☐ Suspected Unapproved ☐		AGAINST DEPARTMENT/PROCESS Skid-tube ☐ Machining ☐ Thermoforming ☐ Large Fab ☐ Cross tube ☐ Small Fab ☐ Finishing ☐ Composite ☐ Water Jet ☐ Prod. Eng. Coord. ☐ Rec/Store/Packaging ☐ Supplier ☐ Engineering ☐ Quality ☐ Other ☐					
Date :		Step #:		QTY Effective :			MRB (QSI042) Approval Completed By _____ Lead hand / Supervisor Approval Verification _____ QC / QA Coordinator Approval _____		
Description Work Order Deviation				Disposition					
Root Cause Environment ☐ Design ☐ Doc/Data ☐ Equip/Tooling ☐ Handling/Pre ☐ Material ☐ Internal Transport ☐ Tribal Knowledge ☐ LOA ☐ Substation ☐ Past Expiry Date ☐ Misidentified ☐ No Re-verification ☐ Operator ☐ Offset/Setup ☐ Supplier ☐ Training ☐ Use for Testing ☐ Poor Information ☐ Rushing ☐ Product Improvement ☐ Process Improvement ☐ Manufacturing Process ☐ Past Due ☐		FAULT CATEGORY Pressure/Forced ☐ Bending ☐ Centre Not Concentric ☐ Cracks ☐ Crimp/Kink/Ripple/Wave ☐ Cuffs ☐ Crushing ☐ Heat Treat ☐ Wave/Twist in Tube ☐ Marks/Chatter ☐ Temperature/Cure ☐ Set-up ☐ BOM/Route ☐ Broken/Damage/Defect ☐ Inspection Incomplete/Unqualified ☐ Contamination ☐ Countersink ☐ Cut Too Short ☐ Instructions Incomplete/Unclear ☐ Drill Holes ☐ Power Loss/Surge ☐ Folio/Program ☐ Grain ☐ Weld ☐ Wrong Stock Pulled ☐ Out of Sequence ☐ Off-set ☐ Mislabeled ☐ Fit/Function ☐ Misaligned/off center ☐ Positioned Wrong ☐ Outside Dimensions ☐ Over/Under tolerance ☐ Part Incorrect ☐ Part Lost/Missing ☐ Part Moved ☐ Drawing ☐ Finish ☐ Misread ☐ Turning Sequence ☐							
		OTHER : ☐							

Picklist Print

Wednesday, May 03, 2017 3:48:54 PM

Page 2

Work Order ID: 160771

160771

Parent Item: 646.9701

646 9701

Parent Item Name: Cutter Sub Assembly

Start Date: 5/8/2017

Required Date: 5/11/2017

Start Qty: 3.00

Required Qty: 3.00

NAS1149FN832P

Purchased

No

110

Each

2,358.000

12

~~30~~ 60

NAS1149FN832P

**

Washer

MAY 05 2017

Location

Loc Qty

Loc Code

GA

358

M135058

208

M136182

40

M136866

110

ST263

2000

M137412

2000

MS21042L08

Purchased

No

110

Each

864.0000

6

~~1830~~ 60

MS21042L08

**

Nut

MAY 05 2017

Location

Loc Qty

Loc Code

GA

108

m135274

6

m135978

102

ST303

756

m137178

28

m137320

128

m137391

600

28
2

DQA: _____ Date: _____



WORK ORDER NON-CONFORMANCE / UPDATE

QA Closed: _____ Date: _____

Work Order update only ☐

Work Order: _____ Part No. _____ NCR No. _____		DISPOSITION Rework ☐ Scrap ☐ Use-as-is ☐ Suspected Unapproved ☐		AGAINST DEPARTMENT/PROCESS Skid-tube ☐ Machining ☐ Thermoforming ☐ Large Fab ☐ Cross tube ☐ Small Fab ☐ Finishing ☐ Composite ☐ Water Jet ☐ Prod. Eng. Coord. ☐ Rec/Store/Packaging ☐ Supplier ☐ Engineering ☐ Quality ☐ Other ☐					
Date :		Step #:		QTY Effective :			MRB (QSI042) Approval		
Description Work Order Deviation				Disposition				Completed By Lead hand / Supervisor Approval Verification QC / QA Coordinator Approval	
Root Cause		FAULT CATEGORY							
Environment ☐	No Re-verification ☐	Pressure/Forced ☐	Temperature/Cure ☐	Power Loss/Surge ☐	Positioned Wrong ☐				
Design ☐	Operator ☐	Bending ☐	Set-up ☐	Folio/Program ☐	Outside Dimensions ☐				
Doc/Data ☐	Offset/Setup ☐	Centre Not Concentric ☐	BOM/Route ☐	Grain ☐	Over/Under tolerance ☐				
Equip/Tooling ☐	Supplier ☐	Cracks ☐	Broken/Damage/Defect ☐	Weld ☐	Part Incorrect ☐				
Handling/Pre ☐	Training ☐	Crimp/Kink/Ripple/Wave ☐	Inspection Incomplete/Unqualified ☐	Wrong Stock Pulled ☐	Part Lost/Missing ☐				
Material ☐	Use for Testing ☐	Cuffs ☐	Contamination ☐	Out of Sequence ☐	Part Moved ☐				
Internal Transport ☐	Poor Information ☐	Crushing ☐	Countersink ☐	Off-set ☐	Drawing ☐				
Tribal Knowledge ☐	Rushing ☐	Heat Treat ☐	Cut Too Short ☐	Mislabeled ☐	Finish ☐				
LOA ☐	Product Improvement ☐	Wave/Twist in Tube ☐	Instructions Incomplete/Unclear ☐	Fit/Function ☐	Misread ☐				
Substation ☐	Process Improvement ☐	Marks/Chatter ☐	Drill Holes ☐	Misaligned/off center ☐	Turning Sequence ☐				
Past Expiry Date ☐	Manufacturing Process ☐								
Misidentified ☐	Past Due ☐	OTHER : _____							



APICAL INDUSTRIES, INC.
dba DART AEROSPACE

TRANSACTION CODES (TC):
A-ADD C-CREATE
R-REVISE D-DELETE

ENGINEERING CHANGE NOTICE NO.

05360

SHEET 1 OF 1

DWG NO. 646.9700

REV: D

PREPARED
BY

J. BECKER

DATE: 03/24/16

EFFECT ON DWG

☐ INC. ☒ UNINC.

DWG TITLE: CUTTER SUB ASSY

APPROVED BY:

ENGR

MFG

QC

EFF.

CURRENT ORDER

REASON: REVISED DIMENSIONS


ECR:

N/A

ACTION ITEM:

1.

SHEET 7, ZONE C3 IS:

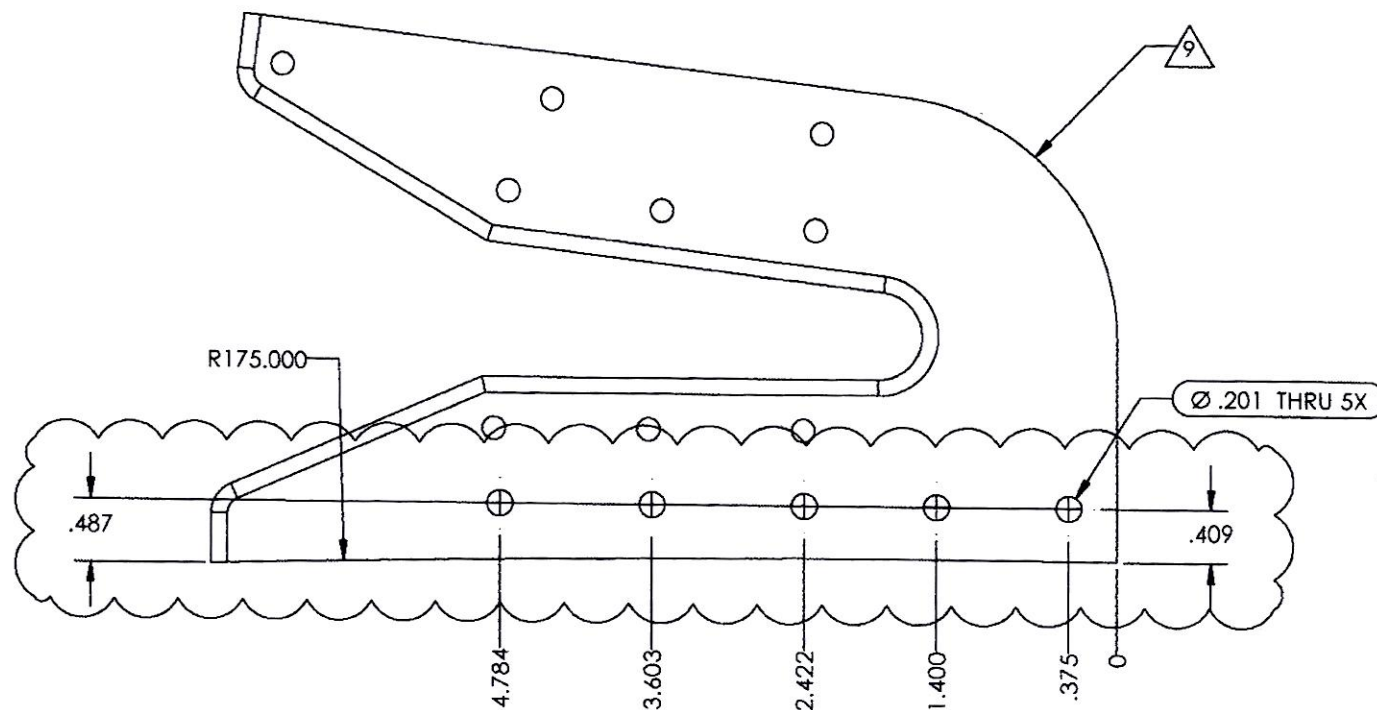

SHOP COPY
RETURN TO
ENGINEERING
UNCONTROLLED COPY
SUBJECT TO AMENDMENT
WITHOUT NOTICE
WORK ORDER
NO. 160771 MW
170504

DOCUMENTS EFFECTED:

☐ PATTERN ☐ MDL ☐ INSTALL INSTRUCTIONS ☐ ICA ☐ FMS ☐ BOM

CHANGE CATEGORY

☐ MAJOR ☒ MINOR

DER REVIEW REQUIRED

☐ YES ☒ NO

DQA: _____ Date: _____



WORK ORDER NON-CONFORMANCE / UPDATE

QA Closed: _____ Date: _____

Work Order update only ☐

Work Order: _____ Part No. _____ NCR No. _____	DISPOSITION Rework ☐ Scrap ☐ Use-as-is ☐ Suspected Unapproved ☐	AGAINST DEPARTMENT/PROCESS Skid-tube ☐ Machining ☐ Thermoforming ☐ Large Fab ☐ Cross tube ☐ Small Fab ☐ Finishing ☐ Composite ☐ Water Jet ☐ Prod. Eng. Coord. ☐ Rec/Store/Packaging ☐ Supplier ☐ Engineering ☐ Quality ☐ Other ☐			
Date :	Step #:	QTY Effective :		MRB (QSI042) Approval	
Description Work Order Deviation		Disposition		Completed By	
				QC / QA Coordinator Approval	
Root Cause		FAULT CATEGORY			
Environment ☐ Design ☐ Doc/Data ☐ Equip/Tooling ☐ Handling/Pre ☐ Material ☐ Internal Transport ☐ Tribal Knowledge ☐ LOA ☐ Substation ☐ Past Expiry Date ☐ Misidentified ☐ No Re-verification ☐ Operator ☐ Offset/Setup ☐ Supplier ☐ Training ☐ Use for Testing ☐ Poor Information ☐ Rushing ☐ Product Improvement ☐ Process Improvement ☐ Manufacturing Process ☐ Past Due ☐	Pressure/Forced ☐ Bending ☐ Centre Not Concentric ☐ Cracks ☐ Crimp/Kink/Ripple/Wave ☐ Cuffs ☐ Crushing ☐ Heat Treat ☐ Wave/Twist in Tube ☐ Marks/Chatter ☐ Temperature/Cure ☐ Set-up ☐ BOM/Route ☐ Broken/Damage/Defect ☐ Inspection Incomplete/Unqualified ☐ Contamination ☐ Countersink ☐ Cut Too Short ☐ Instructions Incomplete/Unclear ☐ Drill Holes ☐	Power Loss/Surge ☐ Folio/Program ☐ Grain ☐ Weld ☐ Wrong Stock Pulled ☐ Out of Sequence ☐ Off-set ☐ Misabeled ☐ Fit/Function ☐ Misaligned/off center ☐ Positioned Wrong ☐ Outside Dimensions ☐ Over/Under tolerance ☐ Part Incorrect ☐ Part Lost/Missing ☐ Part Moved ☐ Drawing ☐ Finish ☐ Misread ☐ Turning Sequence ☐		OTHER :	



APICAL INDUSTRIES, INC.
dba DART AEROSPACE

TRANSACTION CODES (TC):
A-ADD C-CREATE
R-REVISE D-DELETE

ENGINEERING CHANGE NOTICE NO.

05345

SHEET 1 OF 1

DWG NO. 646.9700

REV: D

PREPARED
BY

J. GARDINER

DATE: 03/15/16

EFFECT ON DWG

☐ INC. ☒ UNINC.

DWG TITLE: CUTTER SUB ASSY

APPROVED BY:

ENGR.

MFG

QC

EFF.

CURRENT ORDER

REASON: REVISED NOTES

ECR:

N/A

ACTION ITEM:

1.


SHEET 1, ZONE A6 IS:

NOTES:

IS

- 1 MATERIAL: ALUMINUM 7075-T651 PER AMS-QQ-A-250/12
- 2 FINISH IAW MPP-172 SECTION 2.1, 3.3 & 4.3.
- 3 MATERIAL: AISI A2 TOOL STEEL
CONDITION: ANNEALED
POST PROCESS: HEAT TREAT TO 58-62 Rc ROCKWELL HARDNESS
- 4 FINISH: PRIME IAW MPP-172 SECTION 3.3; 1-2 MIL MAX
5. DEBURR AND BREAK ALL SHARP EDGES EXCEPT WHERE OTHERWISE NOTED
6. IDENTIFY IAW MPP-120
- 7 APPLY F/N 5 AS REQUIRED TO ALL FAYING SURFACES OF F/N 2 UPON ASSEMBLY
- 8 CUTTING EDGE INTENDED TO BE SHARP, DO NOT BREAK SHARP EDGE
- 9 ALL DIMENSIONS NOT SPECIFIED ARE CONTROLLED BY 646.9710.

SHEET 7, ZONE C5 IS:

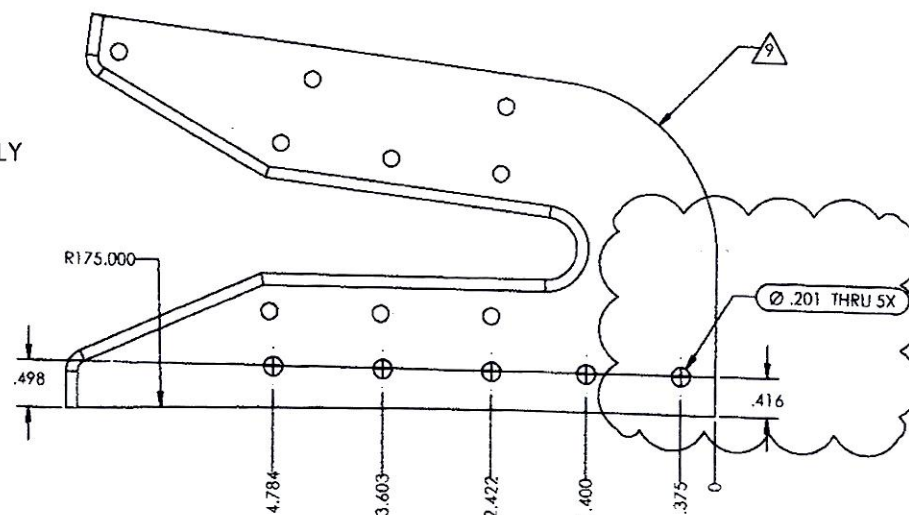

DOCUMENTS EFFECTED:

☐ PATTERN ☐ MDL ☐ INSTALL INSTRUCTIONS ☐ ICA ☐ FMS ☐ BOM

CHANGE CATEGORY

☐ MAJOR ☒ MINOR

DER REVIEW REQUIRED

☐ YES ☒ NO

DQA: _____ Date: _____



WORK ORDER NON-CONFORMANCE / UPDATE

QA Closed: _____ Date: _____

Work Order update only ☐


Work Order: _____ Part No. _____ NCR No. _____		DISPOSITION Rework ☐ Scrap ☐ Use-as-is ☐ Suspected Unapproved ☐		AGAINST DEPARTMENT/PROCESS Skid-tube ☐ Machining ☐ Thermoforming ☐ Large Fab ☐ Cross tube ☐ Small Fab ☐ Finishing ☐ Composite ☐ Water Jet ☐ Prod. Eng. Coord. ☐ Rec/Store/Packaging ☐ Supplier ☐ Engineering ☐ Quality ☐ Other ☐					
Date :		Step #:		QTY Effective :			MRB (QSI042) Approval		
Description Work Order Deviation				Disposition				Completed By Lead hand / Supervisor Approval Verification QC / QA Coordinator Approval	
Root Cause		FAULT CATEGORY							
Environment ☐	No Re-verification ☐	Pressure/Forced ☐	Temperature/Cure ☐	Power Loss/Surge ☐	Positioned Wrong ☐				
Design ☐	Operator ☐	Bending ☐	Set-up ☐	Folio/Program ☐	Outside Dimensions ☐				
Doc/Data ☐	Offset/Setup ☐	Centre Not Concentric ☐	BOM/Route ☐	Grain ☐	Over/Under tolerance ☐				
Equip/Tooling ☐	Supplier ☐	Cracks ☐	Broken/Damage/Defect ☐	Weld ☐	Part Incorrect ☐				
Handling/Pre ☐	Training ☐	Crimp/Kink/Ripple/Wave ☐	Inspection Incomplete/Unqualified ☐	Wrong Stock Pulled ☐	Part Lost/Missing ☐				
Material ☐	Use for Testing ☐	Cuffs ☐	Contamination ☐	Out of Sequence ☐	Part Moved ☐				
Internal Transport ☐	Poor Information ☐	Crushing ☐	Countersink ☐	Off-set ☐	Drawing ☐				
Tribal Knowledge ☐	Rushing ☐	Heat Treat ☐	Cut Too Short ☐	Mislabeled ☐	Finish ☐				
LOA ☐	Product Improvement ☐	Wave/Twist in Tube ☐	Instructions Incomplete/Unclear ☐	Fit/Function ☐	Misread ☐				
Substation ☐	Process Improvement ☐	Marks/Chatter ☐	Drill Holes ☐	Misaligned/off center ☐	Turning Sequence ☐				
Past Expiry Date ☐	Manufacturing Process ☐								
Misidentified ☐	Past Due ☐								
		OTHER :							

THE INFORMATION CONTAINED IN THIS DRAWING IS THE SOLE PROPERTY OF APICAL INDUSTRIES DBA DART AEROSPACE. ANY REPRODUCTION IN PART OR WHOLE WITHOUT THE WRITTEN PERMISSION OF APICAL INDUSTRIES DBA DART AEROSPACE IS PROHIBITED.

REVISIONS			
REV	DESCRIPTION	DATE	APPROVED
	LAST PROTOTYPE REVISION : P02		N/C
NC	INITIAL RELEASE	03/29/09	P. BRAVO
A	INCORPORATED ECH 02744, 03838, 03912	06/06/10	P. BRAVO
B	INCORPORATED FCN 09167	07/05/13	P. BRAVO
C	INCORPORATED ECH 04039	08/05/13	P. BRAVO
D	INCORPORATED ECH 05329	03/28/14	P. BRAVO

NOTES:

- 1 MATERIAL: ALUMINUM 7075-T651 PER AMS-QQ-A-250/12
- 2 FINISH IAW MPP-172 SECTION 3.3 & 4.3.
- 3 MATERIAL: AISI A2 TOOL STEEL
CONDITION: ANNEALED
POST PROCESS: HEAT TREAT TO 58-62 Rc ROCKWELL HARDNESS
- 4 FINISH: PRIME IAW MPP-172 SECTION 3.3: 1-2 MIL MAX
5. DEBURR AND BREAK ALL SHARP EDGES EXCEPT WHERE OTHERWISE NOTED
6. IDENTIFY IAW MPP-120
- 7 APPLY F/N 5 AS REQUIRED TO ALL FAYING SURFACES OF F/N 2 UPON ASSEMBLY
- 8 CUTTING EDGE INTENDED TO BE SHARP. DO NOT BREAK SHARP EDGE
- 9 ALL DIMENSIONS NOT SPECIFIED ARE CONTROLLED BY 646.97/10.

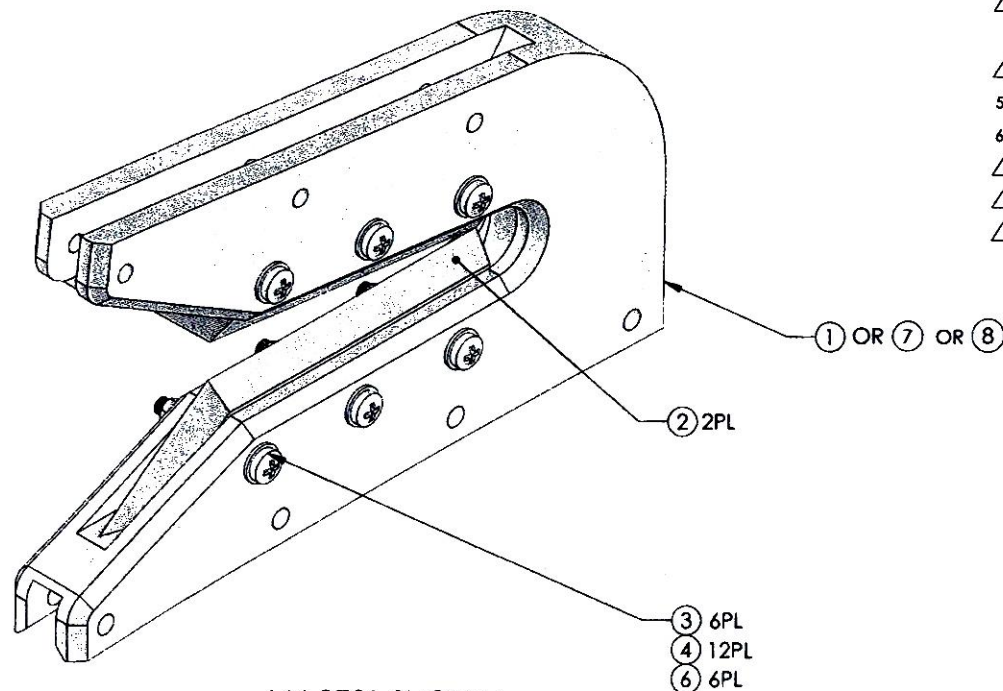

646.9701 SHOWN
646.9702 & 646.9703 TYP

UNINCORPORATED ECN(S)

05345, 05360

1			8	646.9713	BODY		△	△	△
	1		7	646.9712	BODY			△	△
6	6	6	6	601.1541	LOCKNUT		M5271042.08		
A/R	A/R	A/R	5	601.2045	RTV. LOCTITE 598				
12	12	12	4	601.2764	WASHER		MAS11497H832P		
6	6	6	3	601.2765	SCREW		M527039.0519		
2	2	2	2	646.9711	BLADE		△		△
			1	646.9710	BODY				△
X				646.9703	CUTTER SUB ASSY				
	X			646.9702	CUTTER SUB ASSY				
		X		646.9701	CUTTER SUB ASSY				
4703	9702	9701	FIND #	PART #	DESCRIPTION		MAT'L		SPEC.
QTY				PARTS LIST					
NEXT ASSY (S)				DART AEROPACE APCAL INDUSTRIES INC. 0800 DART AEROPACE 3030 ENTERPRISE CI. SUITE A VISTA, CA 92081 (760)-724-5300					
646.9600									
ORIGINAL DATE 05-79-29 DRAWN BY CRONCEP 1. POSHNO P. BRAVO DRAWING APPROVAL CONTRACT NO.									
UNLESS OTHERWISE SPECIFIED DIMENSIONS ARE IN INCHES TOLERANCES ARE: FRACTIONS DECIMALS .001 ANGLES .5° .1° HOLE DIA. .0005									
				CUTTER SUB ASSEMBLY					
				SER. CAGE CODE DWG. NO. REV 8 07MJE 646.9700 1 SCALE: NONE 1 PART 1 OF 2					

DQA: _____ Date: _____



WORK ORDER NON-CONFORMANCE / UPDATE





QA Closed: _____ Date: _____

Work Order update only ☐

Work Order: _____ Part No. _____ NCR No. _____		DISPOSITION Rework ☐ Scrap ☐ Use-as-is ☐ Suspected Unapproved ☐		AGAINST DEPARTMENT/PROCESS Skid-tube ☐ Machining ☐ Thermoforming ☐ Large Fab ☐ Cross tube ☐ Small Fab ☐ Finishing ☐ Composite ☐ Water Jet ☐ Prod. Eng. Coord. ☐ Rec/Store/Packaging ☐ Supplier ☐ Engineering ☐ Quality ☐ Other ☐					
Date :		Step #:		QTY Effective :			MRB (QSI042) Approval		
Description Work Order Deviation				Disposition				Completed By	
								Lead hand / Supervisor Approval Verification	
								QC / QA Coordinator Approval	
Root Cause		FAULT CATEGORY							
Environment ☐	No Re-verification ☐	Pressure/Forced ☐	Temperature/Cure ☐	Power Loss/Surge ☐	Positioned Wrong ☐				
Design ☐	Operator ☐	Bending ☐	Set-up ☐	Folio/Program ☐	Outside Dimensions ☐				
Doc/Data ☐	Offset/Setup ☐	Centre Not Concentric ☐	BOM/Route ☐	Grain ☐	Over/Under tolerance ☐				
Equip/Tooling ☐	Supplier ☐	Cracks ☐	Broken/Damage/Defect ☐	Weld ☐	Part Incorrect ☐				
Handling/Pre ☐	Training ☐	Crimp/Kink/Ripple/Wave ☐	Inspection Incomplete/Unqualified ☐	Wrong Stock Pulled ☐	Part Lost/Missing ☐				
Material ☐	Use for Testing ☐	Cuffs ☐	Contamination ☐	Out of Sequence ☐	Part Moved ☐				
Internal Transport ☐	Poor Information ☐	Crushing ☐	Countersink ☐	Off-set ☐	Drawing ☐				
Tribal Knowledge ☐	Rushing ☐	Heat Treat ☐	Cut Too Short ☐	Mislabeled ☐	Finish ☐				
LOA ☐	Product Improvement ☐	Wave/Twist in Tube ☐	Instructions Incomplete/Unclear ☐	Fit/Function ☐	Misread ☐				
Substation ☐	Process Improvement ☐	Marks/Chatter ☐	Drill Holes ☐	Misaligned/off center ☐	Turning Sequence ☐				
Past Expiry Date ☐	Manufacturing Process ☐								
Misidentified ☐	Past Due ☐	OTHER : ☐							

THE INFORMATION CONTAINED IN THIS DRAWING IS THE SOLE PROPERTY OF APICAL INDUSTRIES DBA DART AEROSPACE. ANY REPRODUCTION IN PART OR WHOLE WITHOUT THE WRITTEN PERMISSION OF APICAL INDUSTRIES DBA DART AEROSPACE IS PROHIBITED.

A
B
C
D

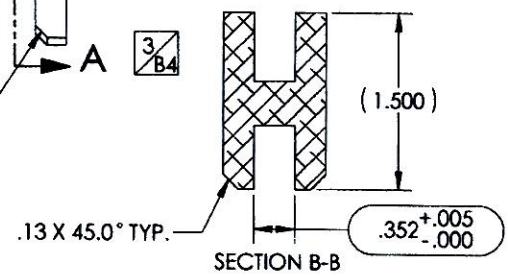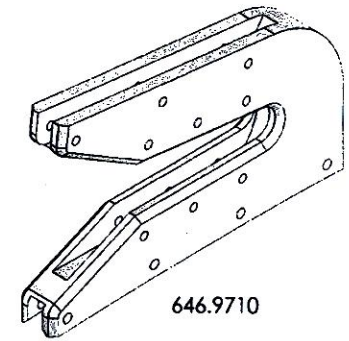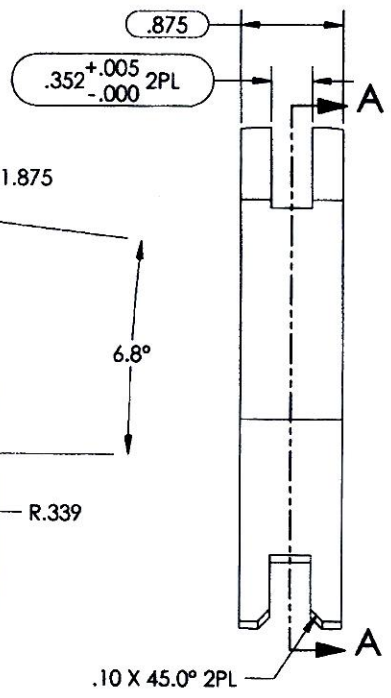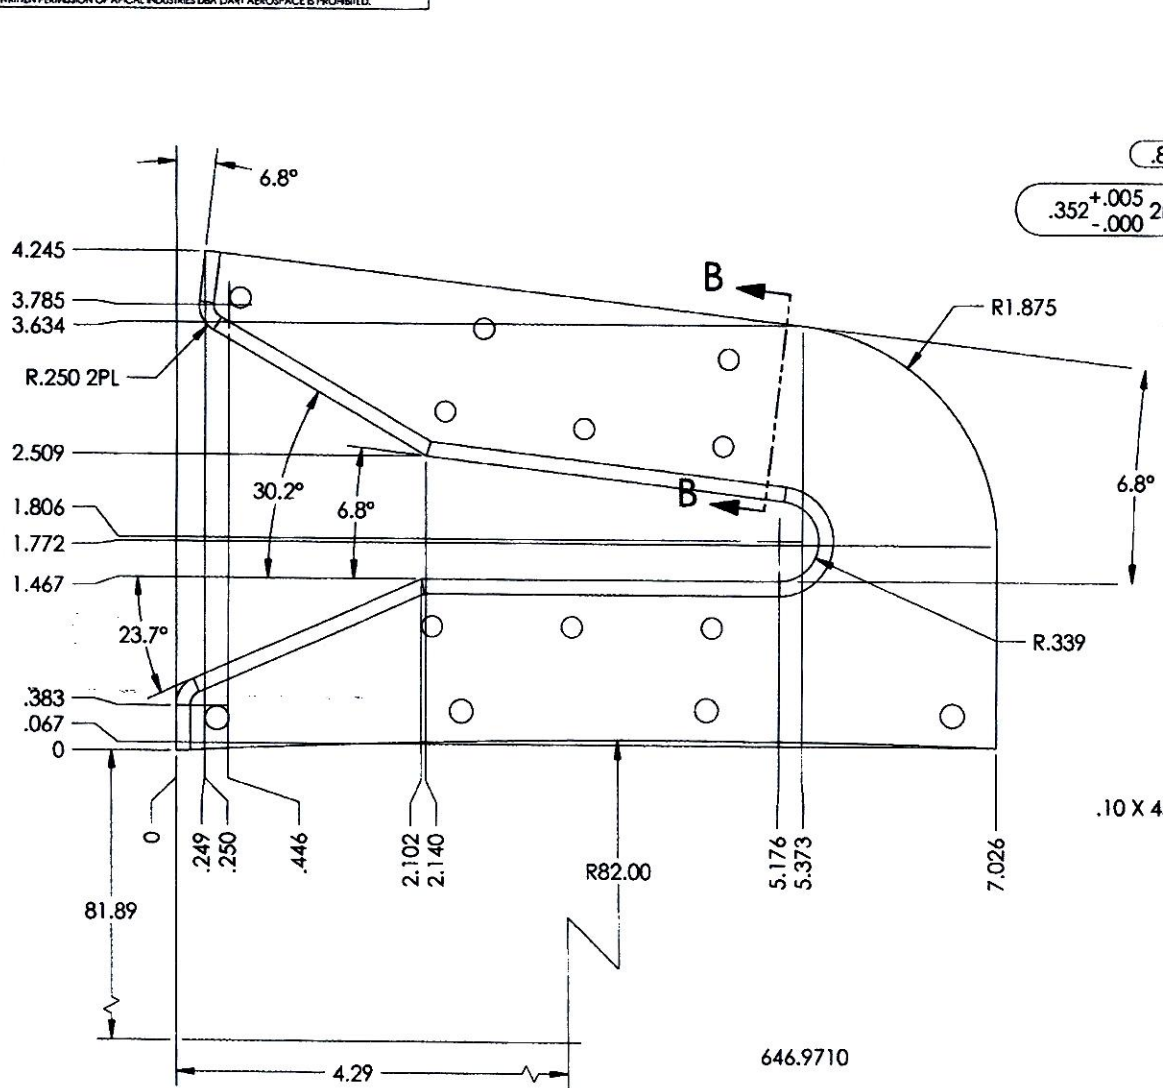

ORIGINAL DATE 10-26-15	05-29-19	DART AEROSPACE APICAL INDUSTRIES, INC. (DBA DART AEROSPACE)	3030 ENTERPRISE CT., SUITE A VISTA, CA 92081 (760)-724-5300
DRAWN BY J. ROSARIO	CHECKED P. BRAYO		
DRAWING APPROVAL P. BRAYO	05-29-19		
CONTRACT NO.			
UNLESS OTHERWISE SPECIFIED DIMENSIONS ARE IN INCHES TOLERANCES ARE: 2 PLACE DECIMALS ±.01 3 PLACE DECIMALS ±.005 ANGLES ±.5°			
SHEET B	CAGE CODE 07MA26	DWG. NO. 646.9700	REV. D
SCALE NONE		SHEET 2 OF 7	

DQA: _____ Date: _____



WORK ORDER NON-CONFORMANCE / UPDATE


QA Closed: _____ Date: _____

Work Order update only ☐

Work Order: _____ Part No. _____ NCR No. _____		DISPOSITION Rework ☐ Scrap ☐ Use-as-is ☐ Suspected Unapproved ☐		AGAINST DEPARTMENT/PROCESS Skid-tube ☐ Machining ☐ Thermoforming ☐ Large Fab ☐ Cross tube ☐ Small Fab ☐ Finishing ☐ Composite ☐ Water Jet ☐ Prod. Eng. Coord. ☐ Rec/Store/Packaging ☐ Supplier ☐ Engineering ☐ Quality ☐ Other ☐					
Date :		Step #:		QTY Effective :			MRB (QSI042) Approval 		
Description Work Order Deviation				Disposition					
								Completed By	
								Lead hand / Supervisor Approval Verification	
								QC / QA Coordinator Approval	

Root Cause			FAULT CATEGORY							
Environment ☐	☐	No Re-verification	☐	Pressure/Forced	☐	Temperature/Cure	☐	Power Loss/Surge	☐	Positioned Wrong
Design ☐	☐	Operator	☐	Bending	☐	Set-up	☐	Folio/Program	☐	Outside Dimensions
Doc/Data ☐	☐	Offset/Setup	☐	Centre Not Concentric	☐	BOM/Route	☐	Grain	☐	Over/Under tolerance
Equip/Tooling ☐	☐	Supplier	☐	Cracks	☐	Broken/Damage/Defect	☐	Weld	☐	Part Incorrect
Handling/Pre ☐	☐	Training	☐	Crimp/Kink/Ripple/Wave	☐	Inspection Incomplete/Unqualified	☐	Wrong Stock Pulled	☐	Part Lost/Missing
Material ☐	☐	Use for Testing	☐	Cuffs	☐	Contamination	☐	Out of Sequence	☐	Part Moved
Internal Transport ☐	☐	Poor Information	☐	Crushing	☐	Countersink	☐	Off-set	☐	Drawing
Tribal Knowledge ☐	☐	Rushing	☐	Heat Treat	☐	Cut Too Short	☐	Mislabeled	☐	Finish
LOA ☐	☐	Product Improvement	☐	Wave/Twist in Tube	☐	Instructions Incomplete/Unclear	☐	Fit/Function	☐	Misread
Substation ☐	☐	Process Improvement	☐	Marks/Chatter	☐	Drill Holes	☐	Misaligned/off center	☐	Turning Sequence
Past Expiry Date ☐	☐	Manufacturing Process	OTHER : _____							
Misidentified ☐	☐	Past Due								

THE INFORMATION CONTAINED IN THIS DRAWING IS THE SOLE PROPERTY OF APICAL INDUSTRIES DBA DART AEROSPACE. ANY REPRODUCTION IN PART OR WHOLE WITHOUT THE WRITTEN PERMISSION OF APICAL INDUSTRIES DBA DART AEROSPACE IS PROHIBITED.

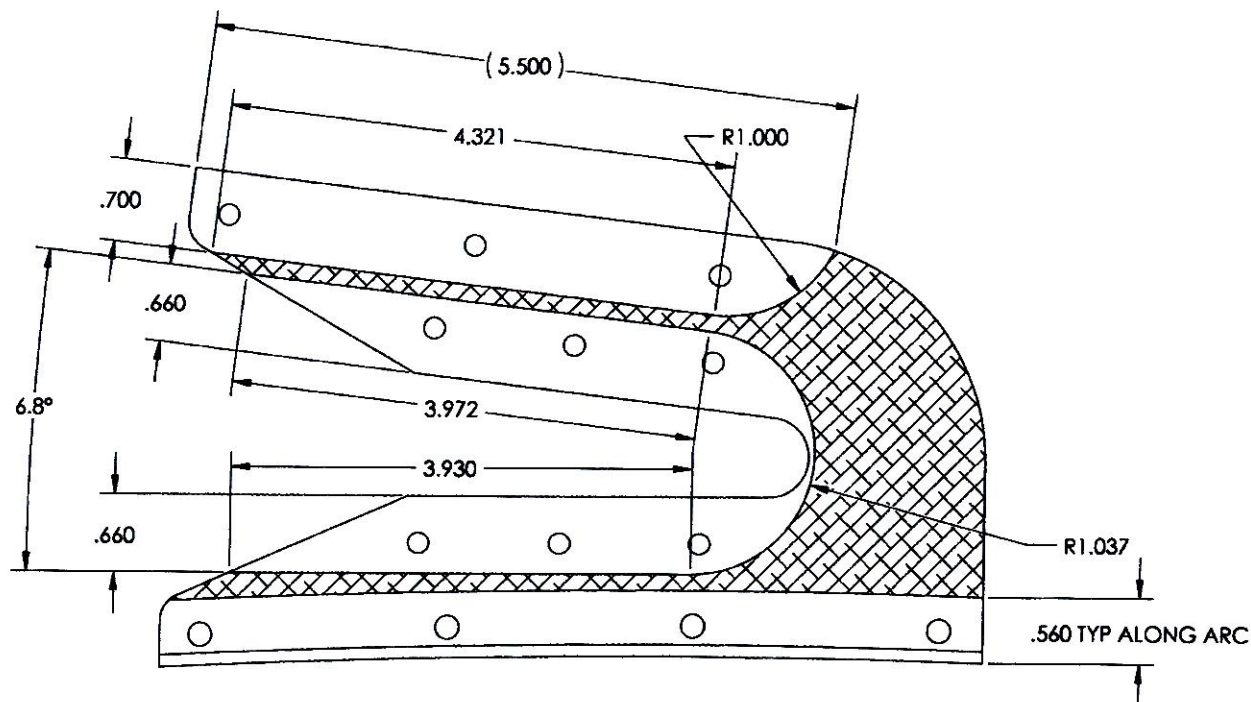

SECTION A-A

646.9710

ORIGINAL DATE 06-20-09		3030 ENTERPRISE CT., SUITE A VISTA, CA 92081 (760) 724-5300	
DRAWN BY R. ROSANO	CHECKED P. BRAVO	DART AEROSPACE APICAL INDUSTRIES INC. DBA DART AEROSPACE	
DESIGNED APPROVAL P. BRAVO 06-20-09		CUTTER SUB ASSEMBLY	
CONTRACT NO.		SEE CAGE CODE B 07M26	DWG. NO. 646.9700
UNLESS OTHERWISE SPECIFIED DIMENSIONS ARE IN INCHES TOLERANCES ARE: 3 PLACE DECIMALS ± .001 ANGLES ± .5°		SCALE: NONE	REV D SHEET 3 OF 7

DQA: _____ Date: _____




WORK ORDER NON-CONFORMANCE / UPDATE

QA Closed: _____ Date: _____

Work Order update only ☐

Work Order: _____ Part No. _____ NCR No. _____		DISPOSITION Rework ☐ Scrap ☐ Use-as-is ☐ Suspected Unapproved ☐		AGAINST DEPARTMENT/PROCESS Skid-tube ☐ Machining ☐ Thermoforming ☐ Large Fab ☐ Cross tube ☐ Small Fab ☐ Finishing ☐ Composite ☐ Water Jet ☐ Prod. Eng. Coord. ☐ Rec/Store/Packaging ☐ Supplier ☐ Engineering ☐ Quality ☐ Other ☐					
Date :		Step #:		QTY Effective :			MRB (QSI042) Approval		
Description Work Order Deviation				Disposition				Completed By	
								Lead hand / Supervisor Approval Verification	
Root Cause		FAULT CATEGORY							
Environment ☐	☐ No Re-verification	☐ Pressure/Forced	☐ Temperature/Cure	☐ Power Loss/Surge	☐ Positioned Wrong				
Design ☐	☐ Operator	☐ Bending	☐ Set-up	☐ Folio/Program	☐ Outside Dimensions				
Doc/Data ☐	☐ Offset/Setup	☐ Centre Not Concentric	☐ BOM/Route	☐ Grain	☐ Over/Under tolerance				
Equip/Tooling ☐	☐ Supplier	☐ Cracks	☐ Broken/Damage/Defect	☐ Weld	☐ Part Incorrect				
Handling/Pre ☐	☐ Training	☐ Crimp/Kink/Ripple/Wave	☐ Inspection Incomplete/Unqualified	☐ Wrong Stock Pulled	☐ Part Lost/Missing				
Material ☐	☐ Use for Testing	☐ Cuffs	☐ Contamination	☐ Out of Sequence	☐ Part Moved				
Internal Transport ☐	☐ Poor Information	☐ Crushing	☐ Countersink	☐ Off-set	☐ Drawing				
Tribal Knowledge ☐	☐ Rushing	☐ Heat Treat	☐ Cut Too Short	☐ Misabeled	☐ Finish				
LOA ☐	☐ Product Improvement	☐ Wave/Twist in Tube	☐ Instructions Incomplete/Unclear	☐ Fit/Function	☐ Misread				
Substation ☐	☐ Process Improvement	☐ Marks/Chatter	☐ Drill Holes	☐ Misaligned/off center	☐ Turning Sequence				
Past Expiry Date ☐	☐ Manufacturing Process	OTHER :							
Misidentified ☐	☐ Past Due								

THE INFORMATION CONTAINED IN THIS DRAWING IS THE SOLE PROPERTY OF APICAL INDUSTRIES DBA DART AEROSPACE. ANY REPRODUCTION IN PART OR WHOLE WITHOUT THE WRITTEN PERMISSION OF APICAL INDUSTRIES DBA DART AEROSPACE IS PROHIBITED.

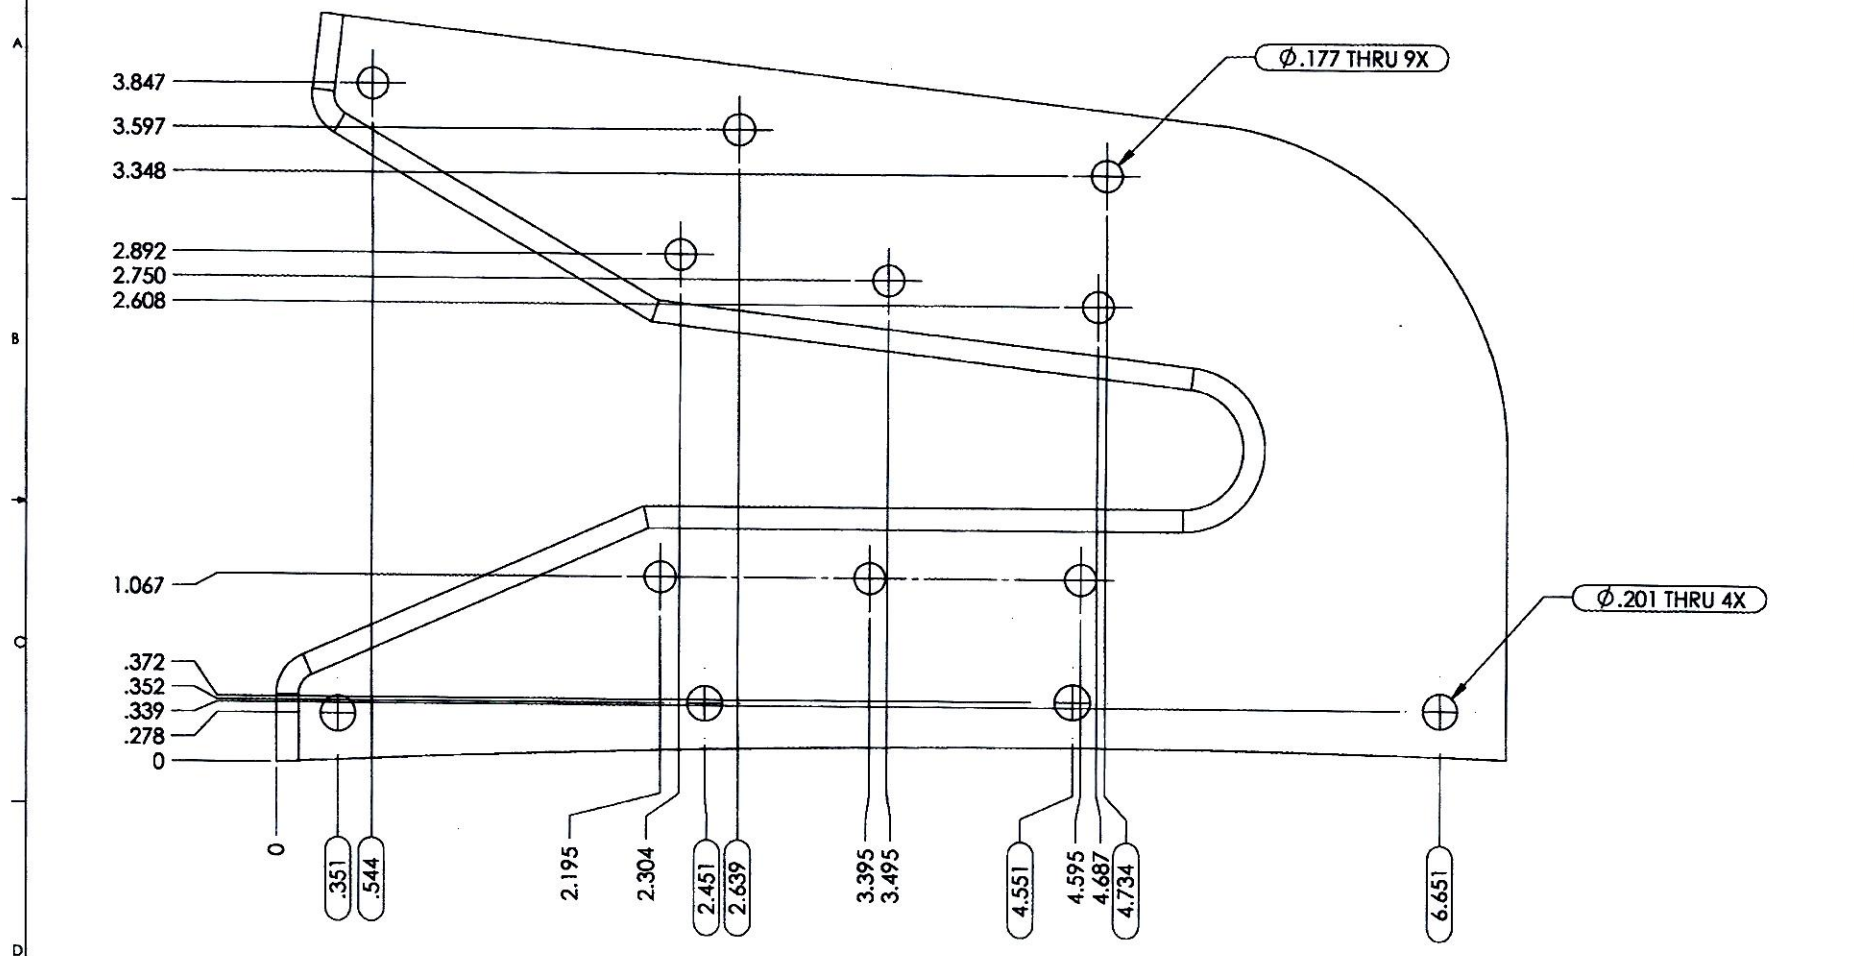

HOLE LOCATIONS +/- .002

646.9710

ORIGINAL DATE 1982-04-19	05-79-09	DART AEROSPACE 3030 ENTERPRISE CT. SUITE A VISTA, CA. 92081 (760)-724-5300 APICAL INDUSTRIES INC. DBA DART AEROSPACE
DRAWN BY R. ROSSANO	CHECKED P. BRAYO	
DESIGNED APPROVAL 05-79-09		
CONTRACT NO.		
UNLESS OTHERWISE SPECIFIED DIMENSIONS ARE IN INCHES TOLERANCES ARE: 2 PLACE DECIMALS ±.01 3 PLACE DECIMALS ±.005 ANGLES ±.5°		SIZE CAGA CODE B 07MA26
DWG. NO. 646.9700		REV. D
SCALE NONE		SHEET 4 OF 7

DQA: _____ Date: _____





WORK ORDER NON-CONFORMANCE / UPDATE

QA Closed: _____ Date: _____



Work Order update only ☐

Work Order: _____ Part No. _____ NCR No. _____		DISPOSITION Rework ☐ Scrap ☐ Use-as-is ☐ Suspected Unapproved ☐		AGAINST DEPARTMENT/PROCESS Skid-tube ☐ Machining ☐ Thermoforming ☐ Large Fab ☐ Cross tube ☐ Small Fab ☐ Finishing ☐ Composite ☐ Water Jet ☐ Prod. Eng. Coord. ☐ Rec/Store/Packaging ☐ Supplier ☐ Engineering ☐ Quality ☐ Other ☐	
Date :		Step #:		QTY Effective :				MRB (QSI042) Approval	
Description Work Order Deviation				Disposition				Completed By Lead hand / Supervisor Approval Verification QC / QA Coordinator Approval	
Root Cause		FAULT CATEGORY	
Environment ☐	No Re-verification ☐	Pressure/Forced ☐	Temperature/Cure ☐	Power Loss/Surge ☐	Positioned Wrong ☐	Design ☐	Operator ☐	Bending ☐	Set-up ☐	Folio/Program ☐	Outside Dimensions ☐	Doc/Data ☐	Offset/Setup ☐	Centre Not Concentric ☐	BOM/Route ☐	Grain ☐	Over/Under tolerance ☐	Equip/Tooling ☐	Supplier ☐	Cracks ☐	Broken/Damage/Defect ☐	Weld ☐	Part Incorrect ☐	Handling/Pre ☐	Training ☐	Crimp/Kink/Ripple/Wave ☐	Inspection Incomplete/Unqualified ☐	Wrong Stock Pulled ☐	Part Lost/Missing ☐	Material ☐	Use for Testing ☐	Cuffs ☐	Contamination ☐	Out of Sequence ☐	Part Moved ☐	Internal Transport ☐	Poor Information ☐	Crushing ☐	Countersink ☐	Off-set ☐	Drawing ☐	Tribal Knowledge ☐	Rushing ☐	Heat Treat ☐	Cut Too Short ☐	Mislabeled ☐	Finish ☐	LOA ☐	Product Improvement ☐	Wave/Twist in Tube ☐	Instructions Incomplete/Unclear ☐	Fit/Function ☐	Misread ☐	Substation ☐	Process Improvement ☐	Marks/Chatter ☐	Drill Holes ☐	Misaligned/off center ☐	Turning Sequence ☐	Past Expiry Date ☐	Manufacturing Process ☐	OTHER :	
Misidentified ☐	Past Due ☐	

THE INFORMATION CONTAINED IN THIS DRAWING IS THE SOLE PROPERTY OF APICAL INDUSTRIES DBA DART AEROSPACE. ANY REPRODUCTION IN PART OR WHOLE WITHOUT THE WRITTEN PERMISSION OF APICAL INDUSTRIES DBA DART AEROSPACE IS PROHIBITED.

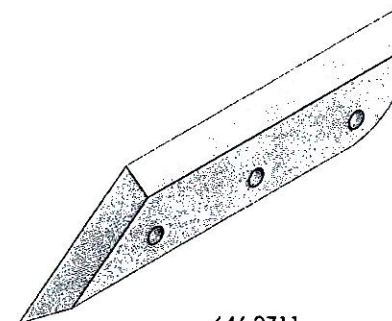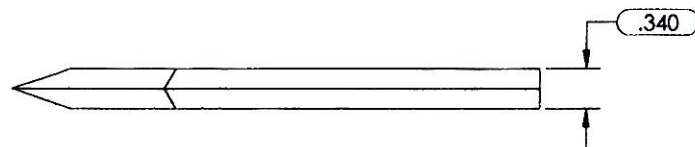



646.9711

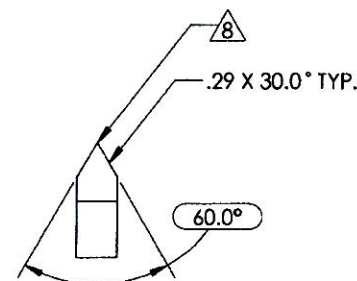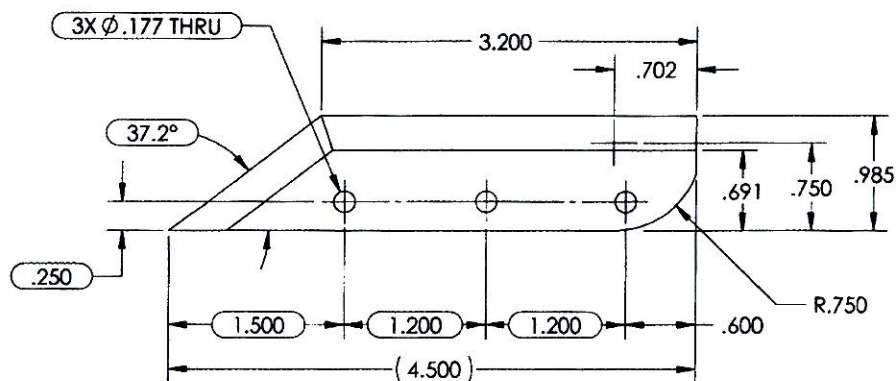

646.9711

ORIGINAL DATE: 05-76-09		3030 ENTERPRISE CT., SUITE A, VISTA, CA. 92081	
DRAWN BY: CHECKER		APICAL INDUSTRIES INC. (760)-724-5300	
BY: ROSARIO		APICAL INDUSTRIES DBA DART AEROSPACE	
DRAWING APPROVAL: P. BLAVO		CUTTER SUB ASSEMBLY	
BY: 72-09		SCALE: NONE	
CONTRACT NO.		SHEET 5 OF 7	
UNLESS OTHERWISE SPECIFIED, DIMENSIONS ARE IN INCHES. TOLERANCES ARE: 2 PLACES DECIMALS ±.01, 3 PLACES DECIMALS ±.005, ANGLES ±.5°		CAGE CODE: 646.9700	
REV. D		DOW: 140	
SHEET 8		D7M26	

THE INFORMATION CONTAINED IN THIS DRAWING IS THE SOLE PROPERTY OF APICAL INDUSTRIES DBA DART AEROSPACE. ANY REPRODUCTION IN PART OR WHOLE WITHOUT THE WRITTEN PERMISSION OF APICAL INDUSTRIES DBA DART AEROSPACE IS PROHIBITED.

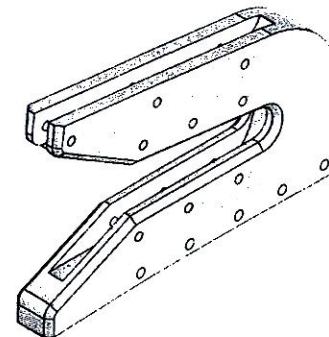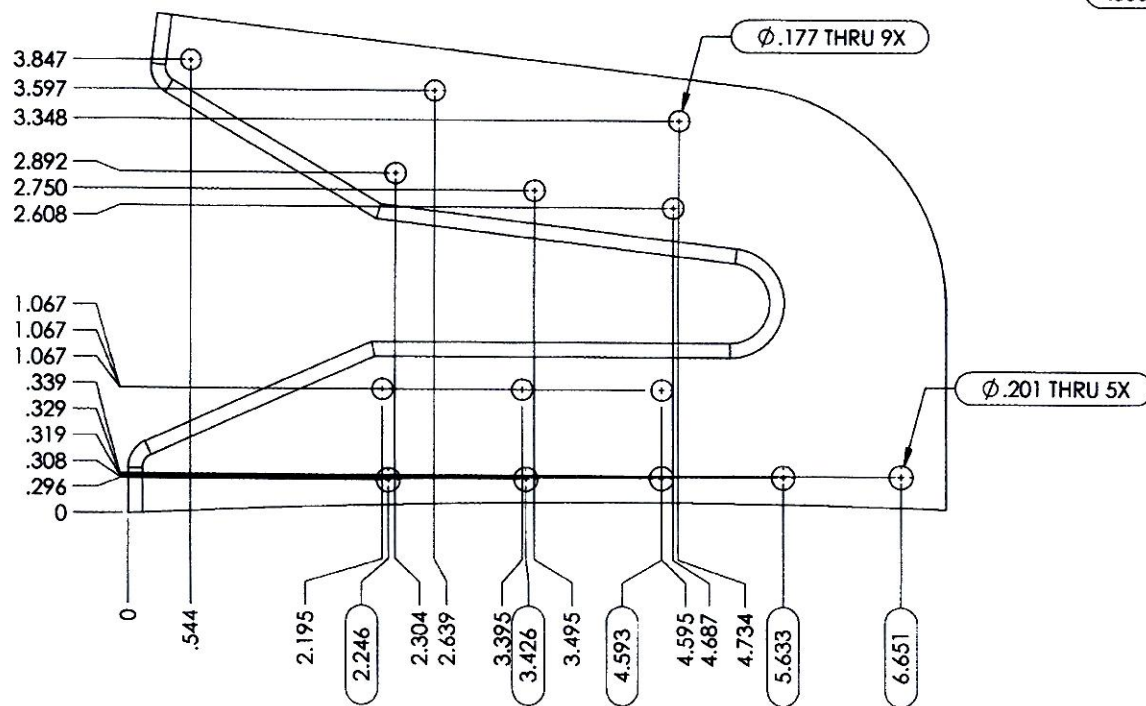


646.9712 9

646.9712

ORIGINAL DATE: 05-29-09		DART AEROSPACE		3030 ENTERPRISE CT., SUITE A	
DRAWN BY: R. ROSANO		CHECKED: P. BRAYO		VISTA, CA. 92081	
DRAWING APPROVAL: P. BRAYO		APICAL INDUSTRIES, INC. (DBA DART AEROSPACE)		(760)-724-5300	
CONTRACT NO.		CUTTER SUB ASSEMBLY			
UNLESS OTHERWISE SPECIFIED, DIMENSIONS ARE IN INCHES.		TOLERANCES ARE:		REV. D	
2 PLACE DECIMALS ±.01		3 PLACE DECIMALS ±.005		ANGLES: 1° ±	
SCALE: NONE		SHEET: 6 OF 7		CAGE CODE: 646.9700	

THE INFORMATION CONTAINED IN THIS DRAWING IS THE SOLE PROPERTY OF APCAL INDUSTRIES DBA DART AEROSPACE. ANY REPRODUCTION IN PART OR WHOLE WITHOUT THE WRITTEN PERMISSION OF APCAL INDUSTRIES DBA DART AEROSPACE IS PROHIBITED.

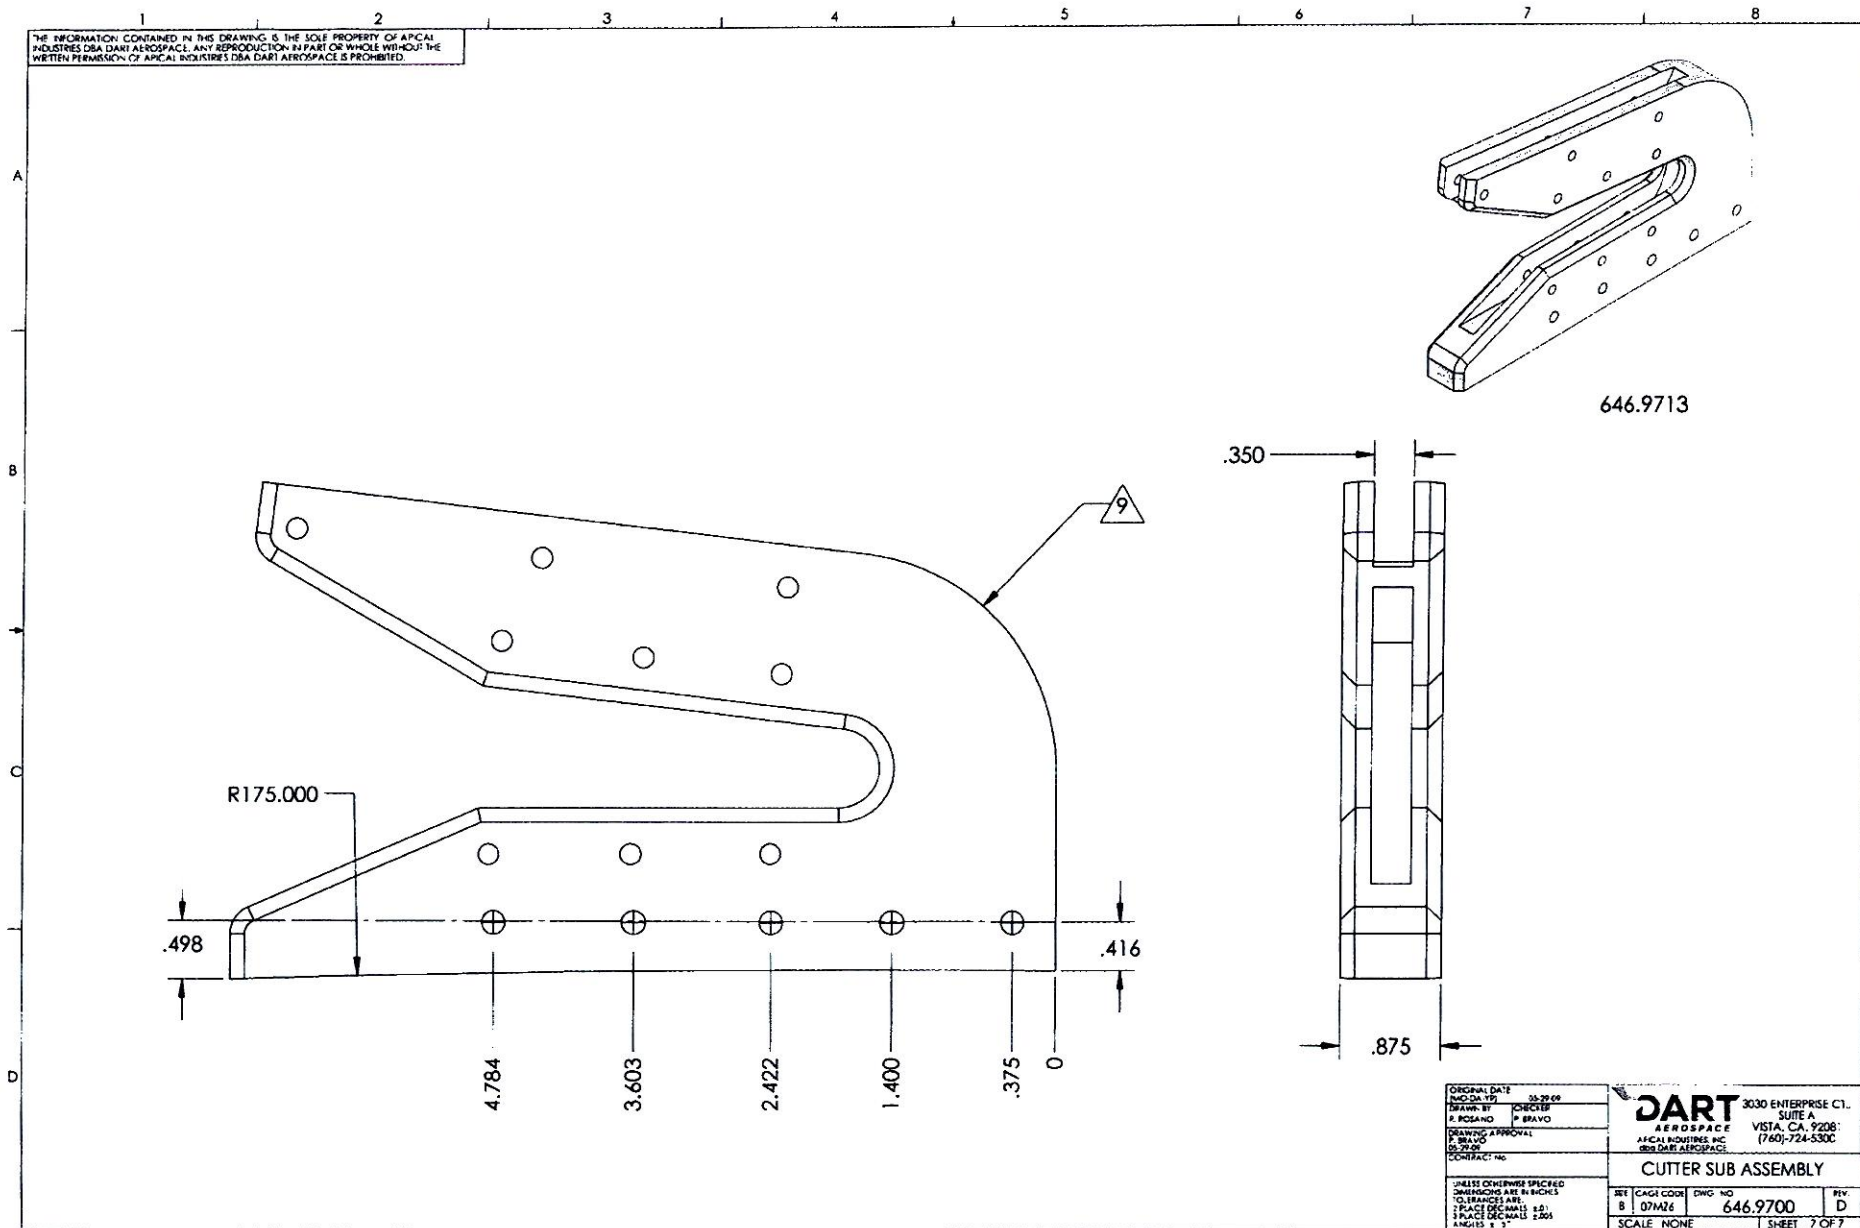

ORIGINAL DATE MCO DA 101		35-29-09	DART 3030 ENTERPRISE C1.	
DRAWN BY P. ROSANO		CHECKED P. BRAVO	SUITE A	
DRAWING APPROVAL P. BRAVO		05-29-09	AEROSPACE VISTA, CA, 92081	
CONTRACT NO.			(760)-724-5300	
UNLESS OTHERWISE SPECIFIED DIMENSIONS ARE IN INCHES TOLERANCES ARE: 2 PLACE DECIMALS ±.01 3 PLACE DECIMALS ±.005 ANGLES ±.5°			CUTTER SUB ASSEMBLY	
REV	CAGE CODE	DWG NO	REV	
8	07M26	646.9700	D	
SCALE NONE		SHEET 7 OF 7		